


First Floor


SD = Smoke Detector Red Line = Fire Wall FD30 repositioned as shown

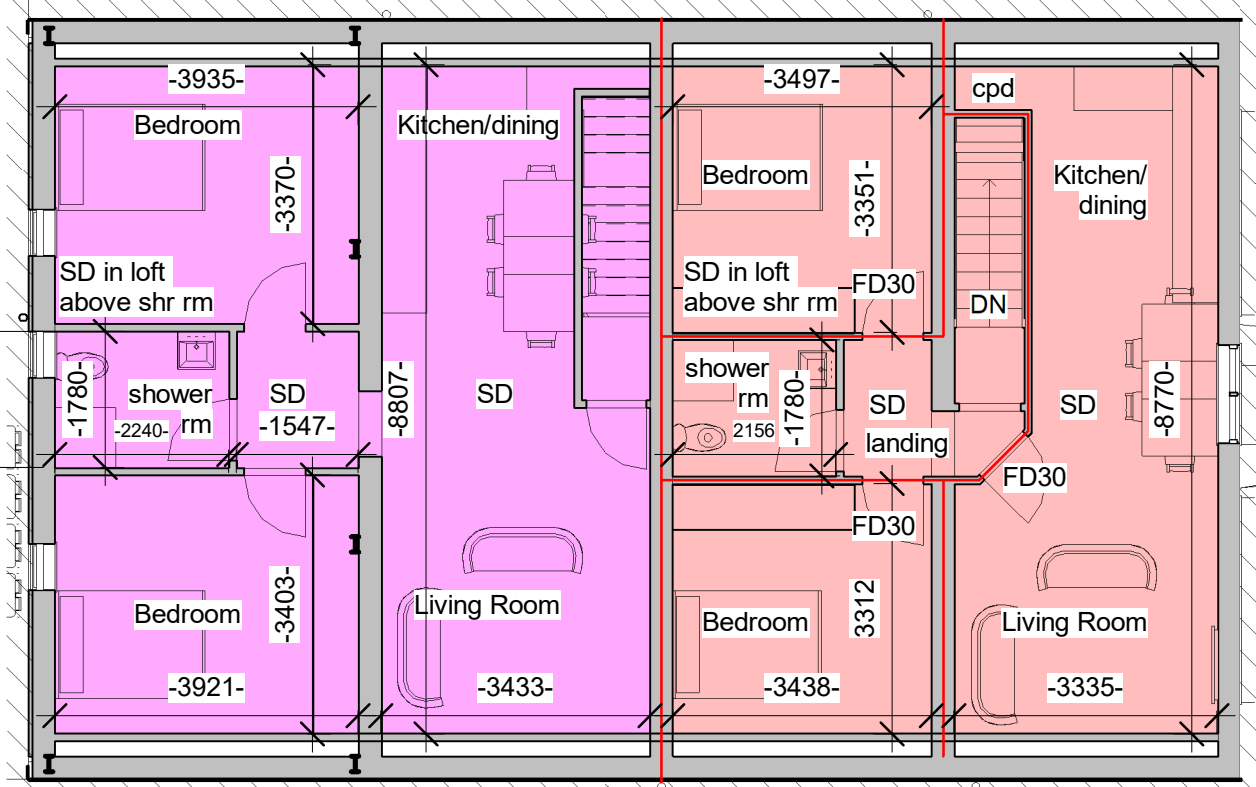

2 bed flat No4

2 bed flat No3

Ground Floor

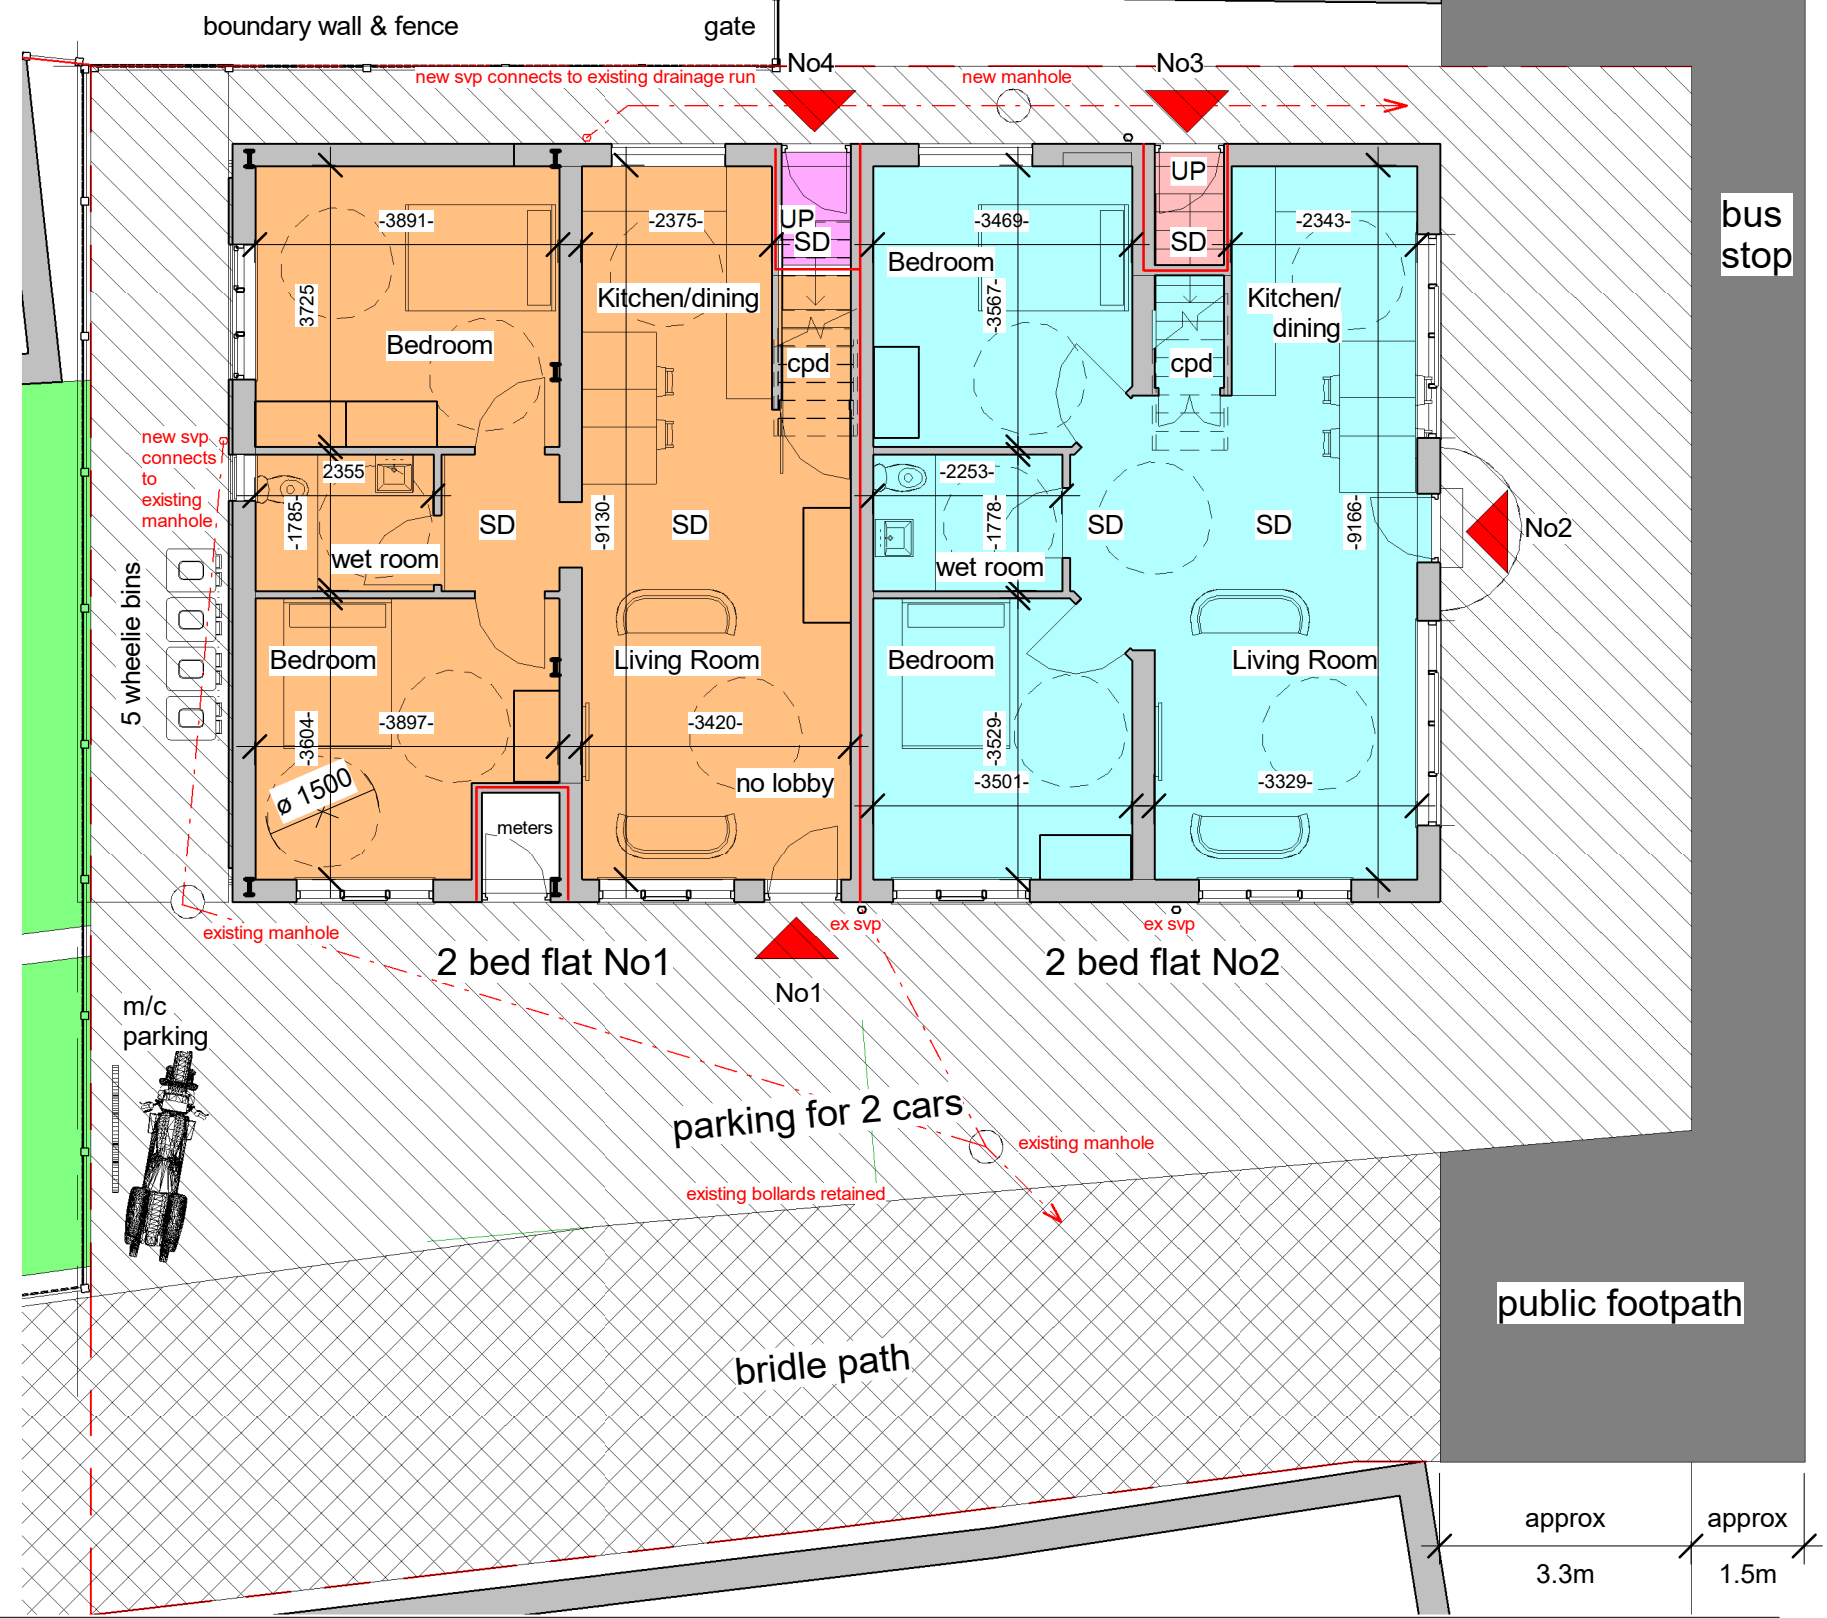

2 bed flat No1

2 bed flat No2



Completed Front Elevation

1 : 100

3

THIS DRAWING AND CAD DATA THEREIN IS PROTECTED BY COPYRIGHT AND MUST NOT BE COPIED OR REPRODUCED WITHOUT THE WRITTEN CONSENT OF OWLarchitecture.com
 NO DIMENSIONS ARE TO BE SCALED FROM THIS DRAWING. USE FIGURED DIMENSIONS ONLY.
 ALL DIMENSIONS AND SIZES ARE TO BE CHECKED ON SITE AND ANY DISCREPANCIES ARE TO BE REPORTED TO THE ARCHITECT IMMEDIATELY.
 OWLarchitecture.com

No
 Job Name
Flats 1-4
 No10 Main Street
 Barwick-in-Elmet LS15 4JQ
 Drawing Title
Completed Floor Plans

Status
Completed & Checked
 Sheet By
GJW
 Scale at A3 - double scale at A1
1 : 100
 Job Number
1230
 Drawing Number
4020
 Issued Date
27/05/2021

Mob 0771 898 6000
 25 Crescent View
 Alwoodley
 Leeds
 LS17 7QF
 West Yorkshire


OWL architecture.com

Scale set for printing at A3 thus the Scale is Doubled at A1. For example; A drawing set to print at Scale 1:200 at A3 becomes scale 1:100 when it is printed at A1.


South Elevation




Section

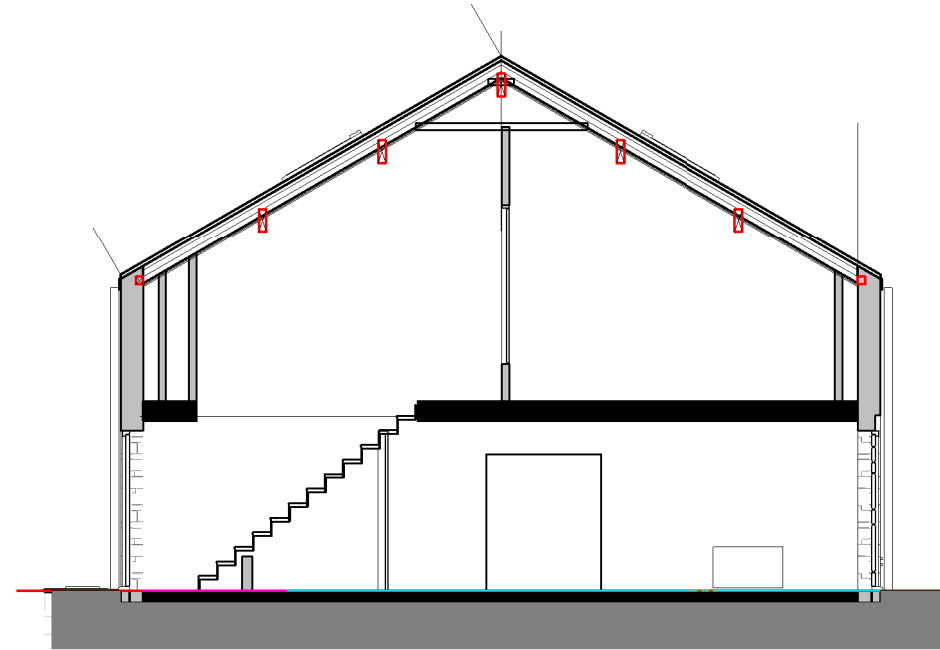

West Elevation

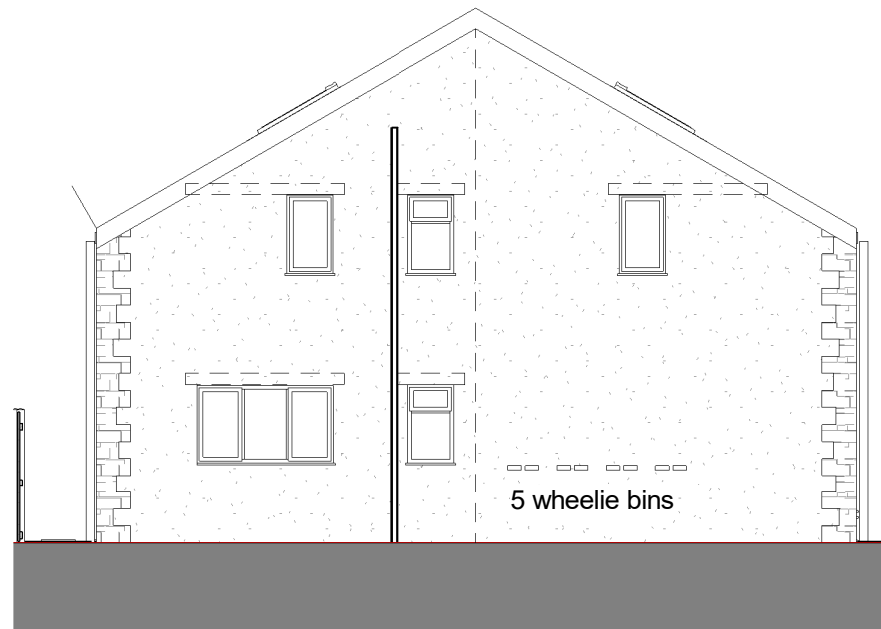

North Elevation

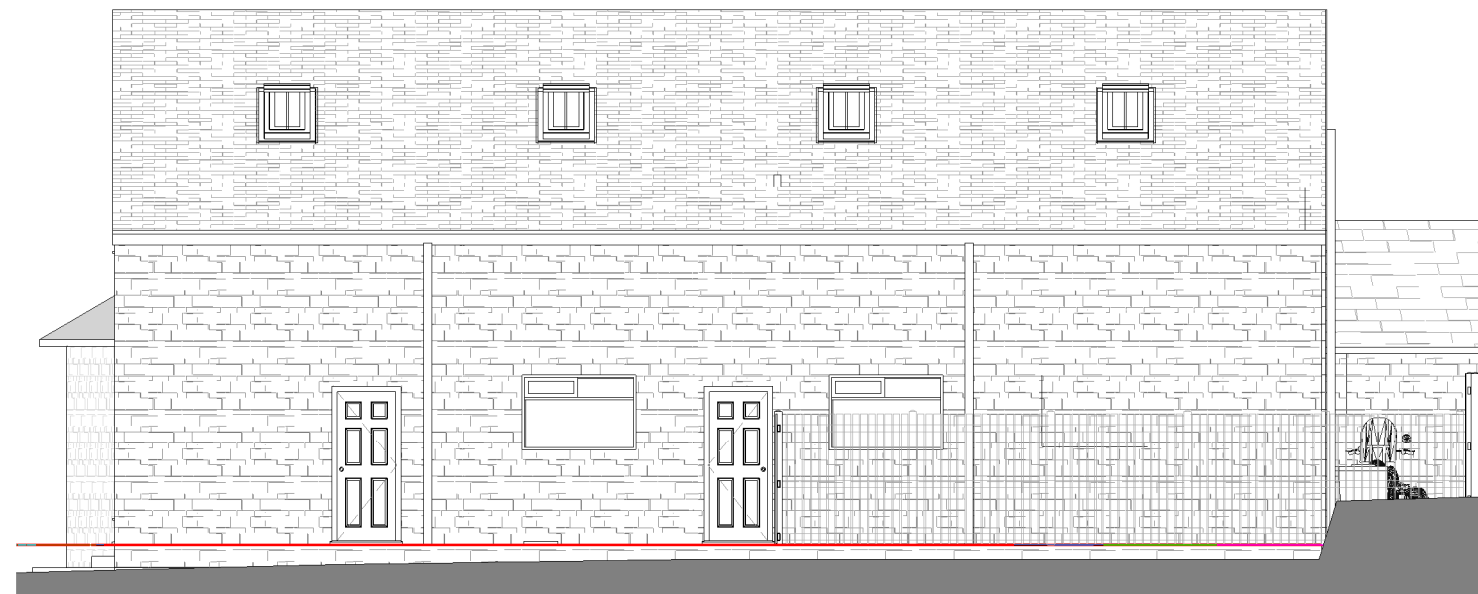

THIS DRAWING AND CAD DATA THEREIN IS PROTECTED BY
COPYRIGHT
AND MUST NOT BE COPIED OR REPRODUCED
WITHOUT THE WRITTEN CONSENT OF
OwlArchitecture.com

NO DIMENSIONS ARE TO BE SCALED FROM THIS DRAWING.
USE FIGURED DIMENSIONS ONLY.
ALL DIMENSIONS AND SIZES ARE TO BE CHECKED ON SITE
AND ANY DISCREPANCIES REPORTED TO THE ARCHITECT
PRIOR TO INITIATION OF ANY WORKS.

No
Job Name
Flats 1-4
No10 Main Street
Barwick-in-Elmet LS15 4JQ
Drawing Title
Completed Elevations

Status
Completed & Checked
Sheet By
GJW
Scale at A3 - double scale at A1
1 : 100
Job Number
1230
Drawing Number
4021
Issued Date
27/05/2021

Mob 0771 898 6000
25 Crescent View
Alwoodley
Leeds
LS17 7QF
West Yorkshire

OWL architecture.com